


**LOCATION MAP**  
NOT TO SCALE

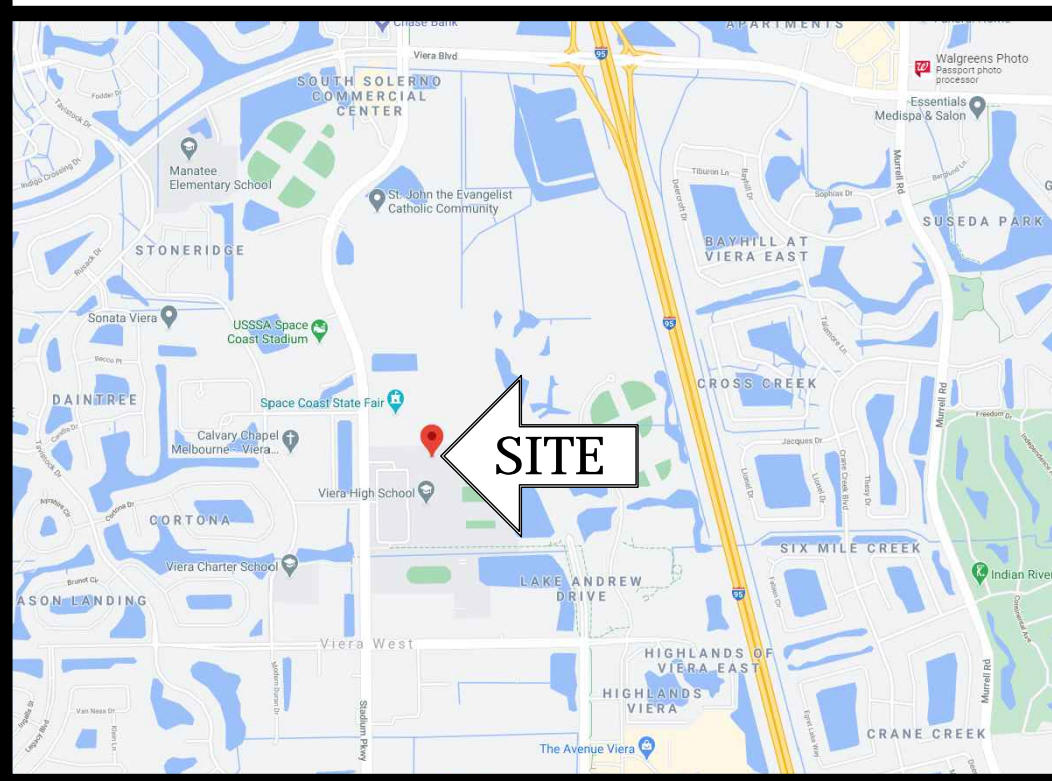

**ABBREVIATIONS:**

BLDG.	BUILDING
CHH	COMMUNICATIONS HANDHOLE
CO	CLEANOUT
CONC.	CONCRETE
CU	COPPER
DS	DOWNSPROUT
EHH	ELECTRIC HANDHOLE
ELEC.	ELECTRIC
EV	ELECTRIC VAULT
EXST.	EXISTING
FFE	FINISHED FLOOR ELEVATION
INV.	INVERT
LF	LINEAR FEET
SAN.	SANITARY
SDx	STORM DRAINAGE PIPE
SSx	SANITARY SEWER PIPE
T.O.P.	TOP OF PIPE ELEVATION
WM	WATER METER
WV	WATER VALVE
WL	WATER LINE PIPE

**SURVEYOR'S NOTES:**

- THIS IS NOT A BOUNDARY SURVEY. For boundary information, refer to Boundary & Topographic Survey of a portion of Section 4, Township 26 S., Range 36 E., Job No. 030123, dated May 26, 2004 by Allen Engineering, Inc. for the School Board of Brevard County.
- The elevations shown herein are based on Florida Department of Transportation Benchmark "7-95 J-11" in east headwall of box culvert under I-95 at the Viera Boulevard interchange. Elevation = 29.606 feet, National Geodetic Vertical Datum of 1929.
- Only above ground evidence of utilities was located by this survey.

**SURVEYOR'S CERTIFICATION:**

I hereby certify that the attached sketch is an accurate representation of an As-built Survey, performed under my direction, in accordance with all applicable requirements of the "Standards of Practice" as described in Chapter 5J-17 Florida Administrative Code, pursuant to Chapter 472.027, Florida Statutes.

Not valid without the signature and the original raised seal of a Florida licensed surveyor and mapper.

BY: DAVID J. IRWIN  
Professional Surveyor & Mapper  
Florida Registration No. 6672  
ALLEN ENGINEERING, INC.

NO.	DATE	FB/PG	REVISIONS	CHK'D

# Exhibit A

COPYRIGHT © 2020 ALLEN ENGINEERING, INC. FB 536/17

FOR:	<b>WHARTON-SMITH, INC.</b>	SURVEY DATE	11-20-20
	SKETCH OF <b>AS-BUILT SURVEY</b> <b>VIERA HIGH SCHOOL</b> <b>6103 STADIUM PARKWAY</b> <b>MELBOURNE</b> <b>BREVARD COUNTY, FLORIDA</b>	SCALE	1"=20'
	<b>ALLEN ENGINEERING, INC.</b> FLORIDA CERTIFICATE OF AUTHORIZATION No. LB 266 106 DIXIE LANE COCOA BEACH, FLORIDA 32931 TELEPHONE: (321)783-7443 - FAX: (321)783-5902 WEBSITE: www.alleneng.net - EMAIL: bsalmon@alleneng.net	JOB NO.	030123.14
		DRAWN	DJG
		SHEET NO.	1 OF 1